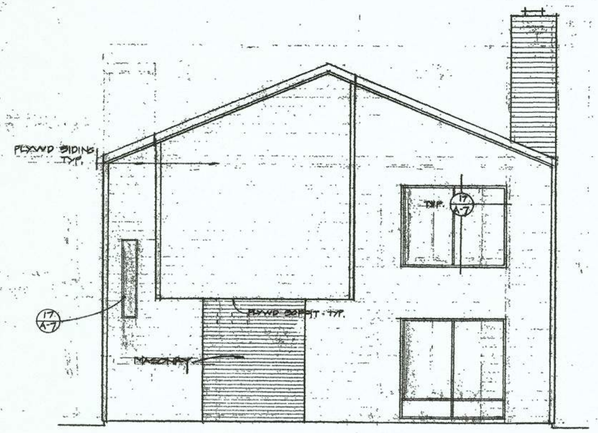

ELEVATION 1
SCALE: 1/4" = 1'-0"

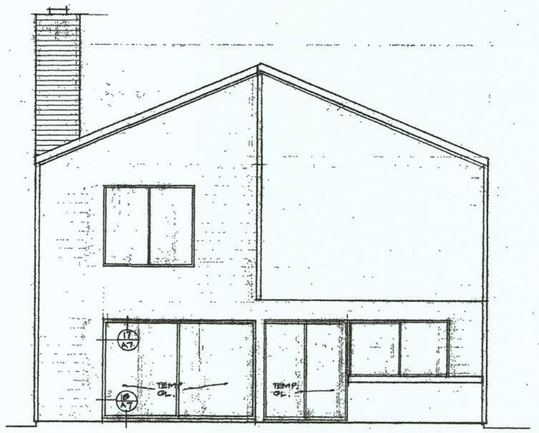

ELEVATION 2
SCALE: 1/4" = 1'-0"

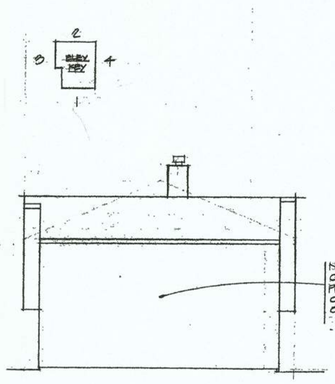

ELEVATION 4
SCALE: 1/8" = 1'-0"

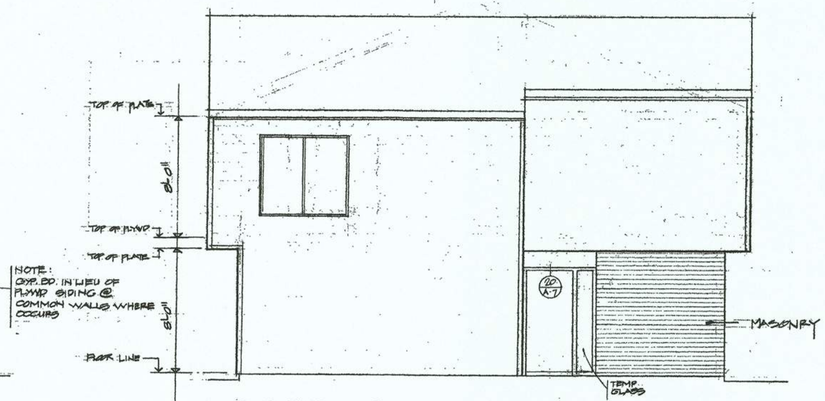

ELEVATION 3
SCALE: 1/4" = 1'-0"

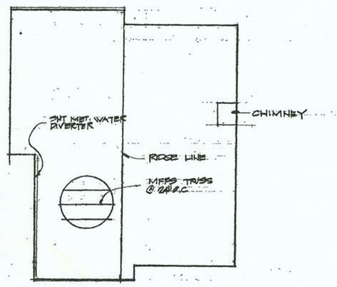

ROOF PLAN
SCALE: 1/8" = 1'-0"

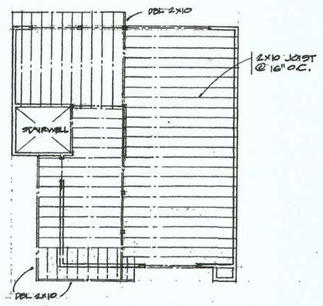

SECOND FLOOR FRAMING PLAN
SCALE: 1/8" = 1'-0"

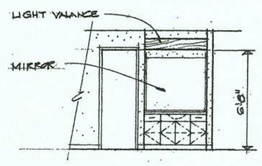

MASTER BATH VANITY
SCALE: 1/4" = 1'-0"

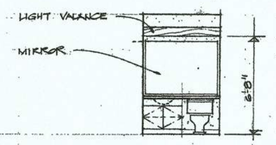

VANITY ELEVATION
SCALE: 1/4" = 1'-0"

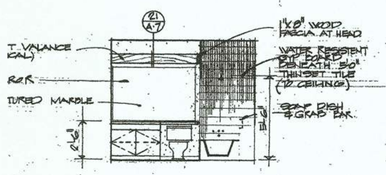

TH ELEVATION 2ND FL.
LE: 1/4" = 1'-0"

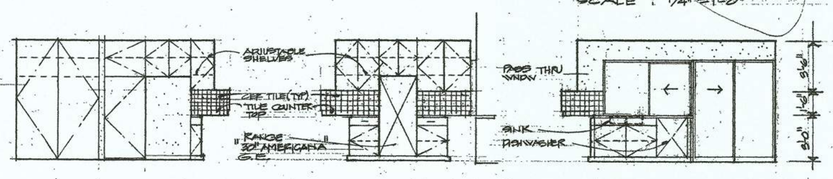

KITCHEN CABINET ELEVATION
SCALE: 1/4" = 1'-0"

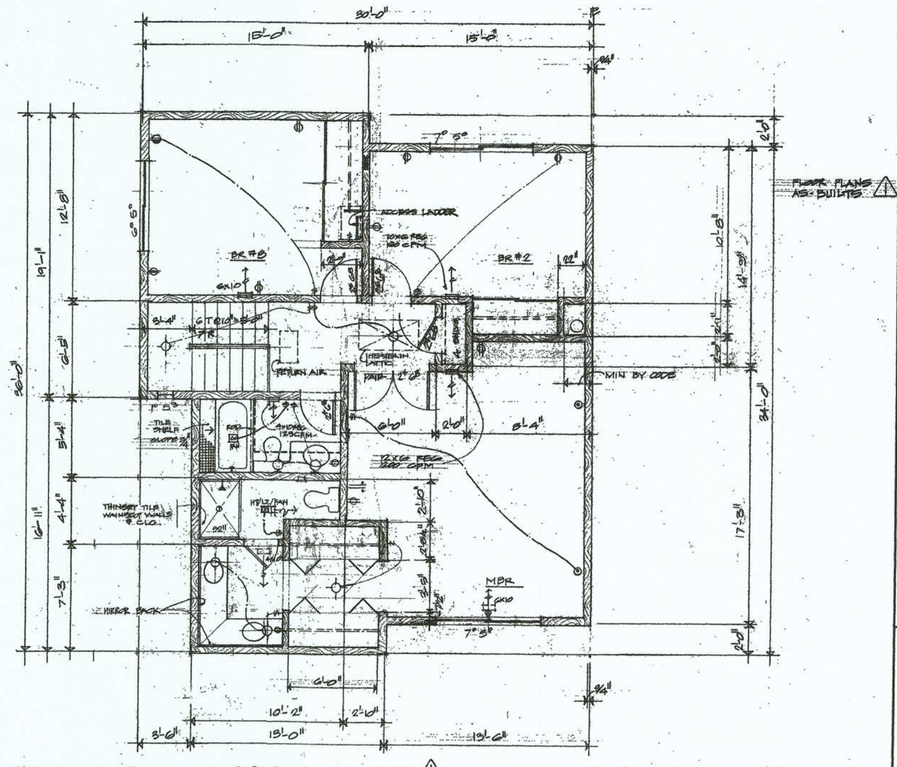

SECOND FLOOR PLAN ⚠1
SCALE: 1/4" = 1'-0"

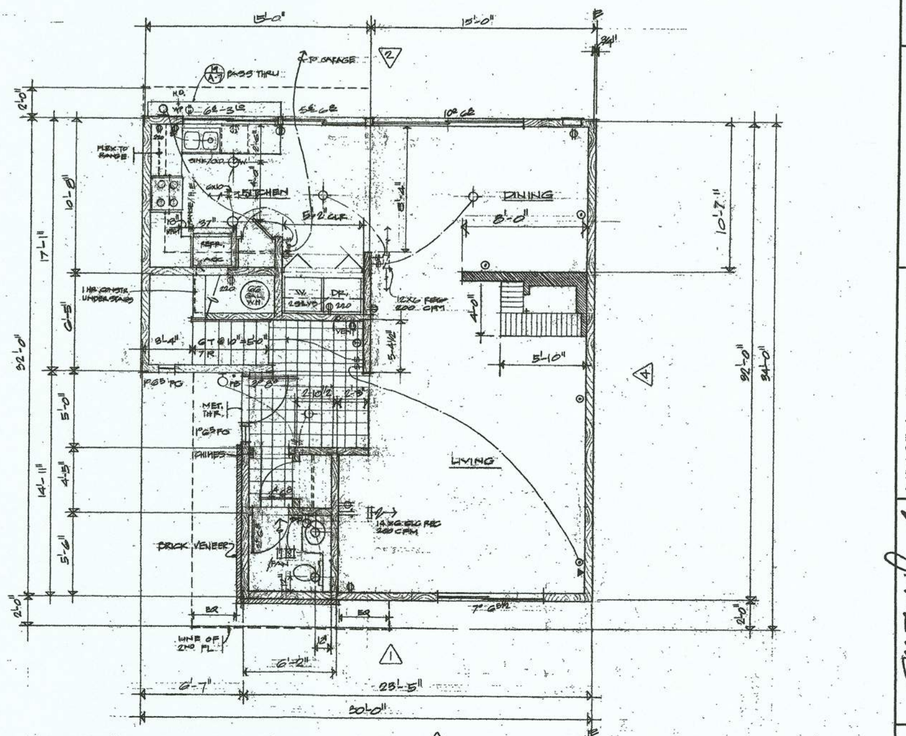

FIRST FLOOR PLAN ⚠1
SCALE: 1/4" = 1'-0"

FLOOR PLANS AS-BUILTS ⚠1

Drawn	Checked
Date OCT 15 '73	

Revision Date	By Ap
OCT 23 '73	
OCT 31 '73	
NOV 7 '73	
16 JAN 74	A
18 JAN 74	A
29 APR 74	A

This drawing is not final or to be used for construction until it is signed by the Architect and the Owner.

POWELL - TEICHERT MEADOWS

CAMPUS COMMONS UNITS 1-7

Architect: Albert M. Dreyfuss, Leonard D. Blackford
Architects California Certificate Number C 1189, C 1813

Dreyfuss & Blackford
Architects & Planners
3540 Folsom Boulevard, Sacramento, California 452-5661

Owner

Sheet Number A5

of Sheets